CITY OF FRASER

MACOMB COUNTY, MICHIGAN

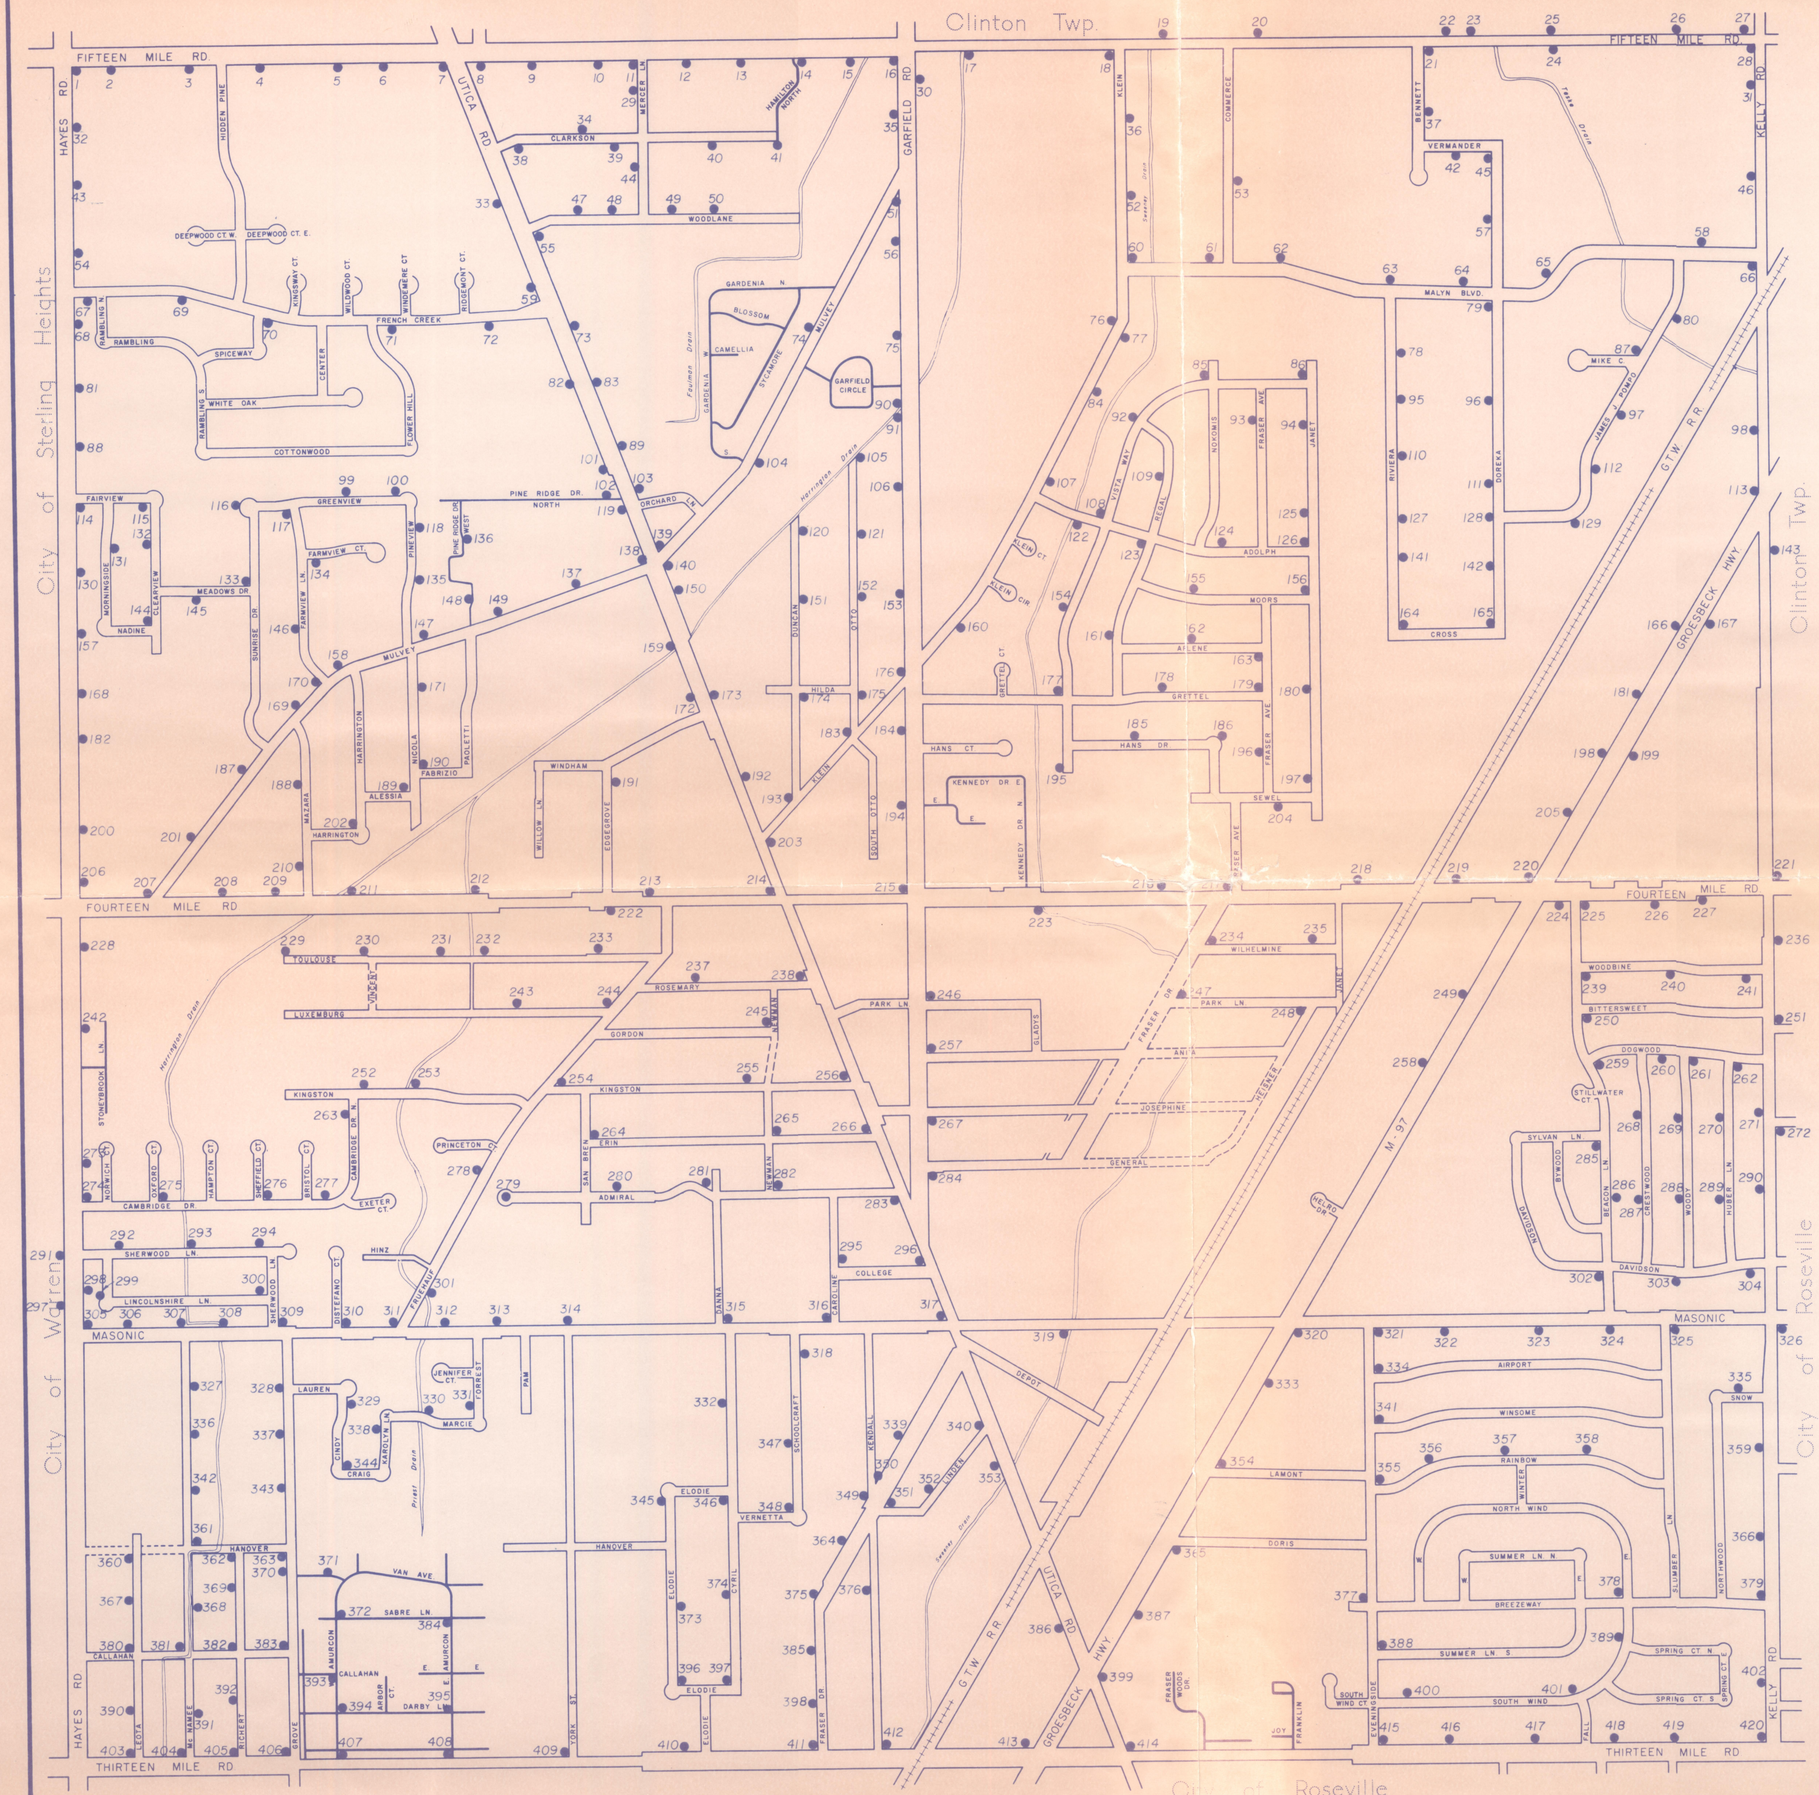

DRAWN BY LAS	CITY OF FRASER, MICHIGAN
CHECKED BY	BENCH MARKS
DATE JUNE, 1994	N.G.V.D. DATUM
SCALE 1" = 700'±	
AS BUILT	PATE, HIRN & BOGUE INC.
SHEET 1 OF 1	CIVIL ENGINEERS
ORDER NO. 1496 2	17000 TWELVE MILE ROAD
FILE NO. 25-B-204	SOUTHFIELD, MICHIGAN 48076

POST N78763